


STORM SEWER AS-BUILTS

BOROUGH OF AUDUBON CAMDEN COUNTY, NEW JERSEY

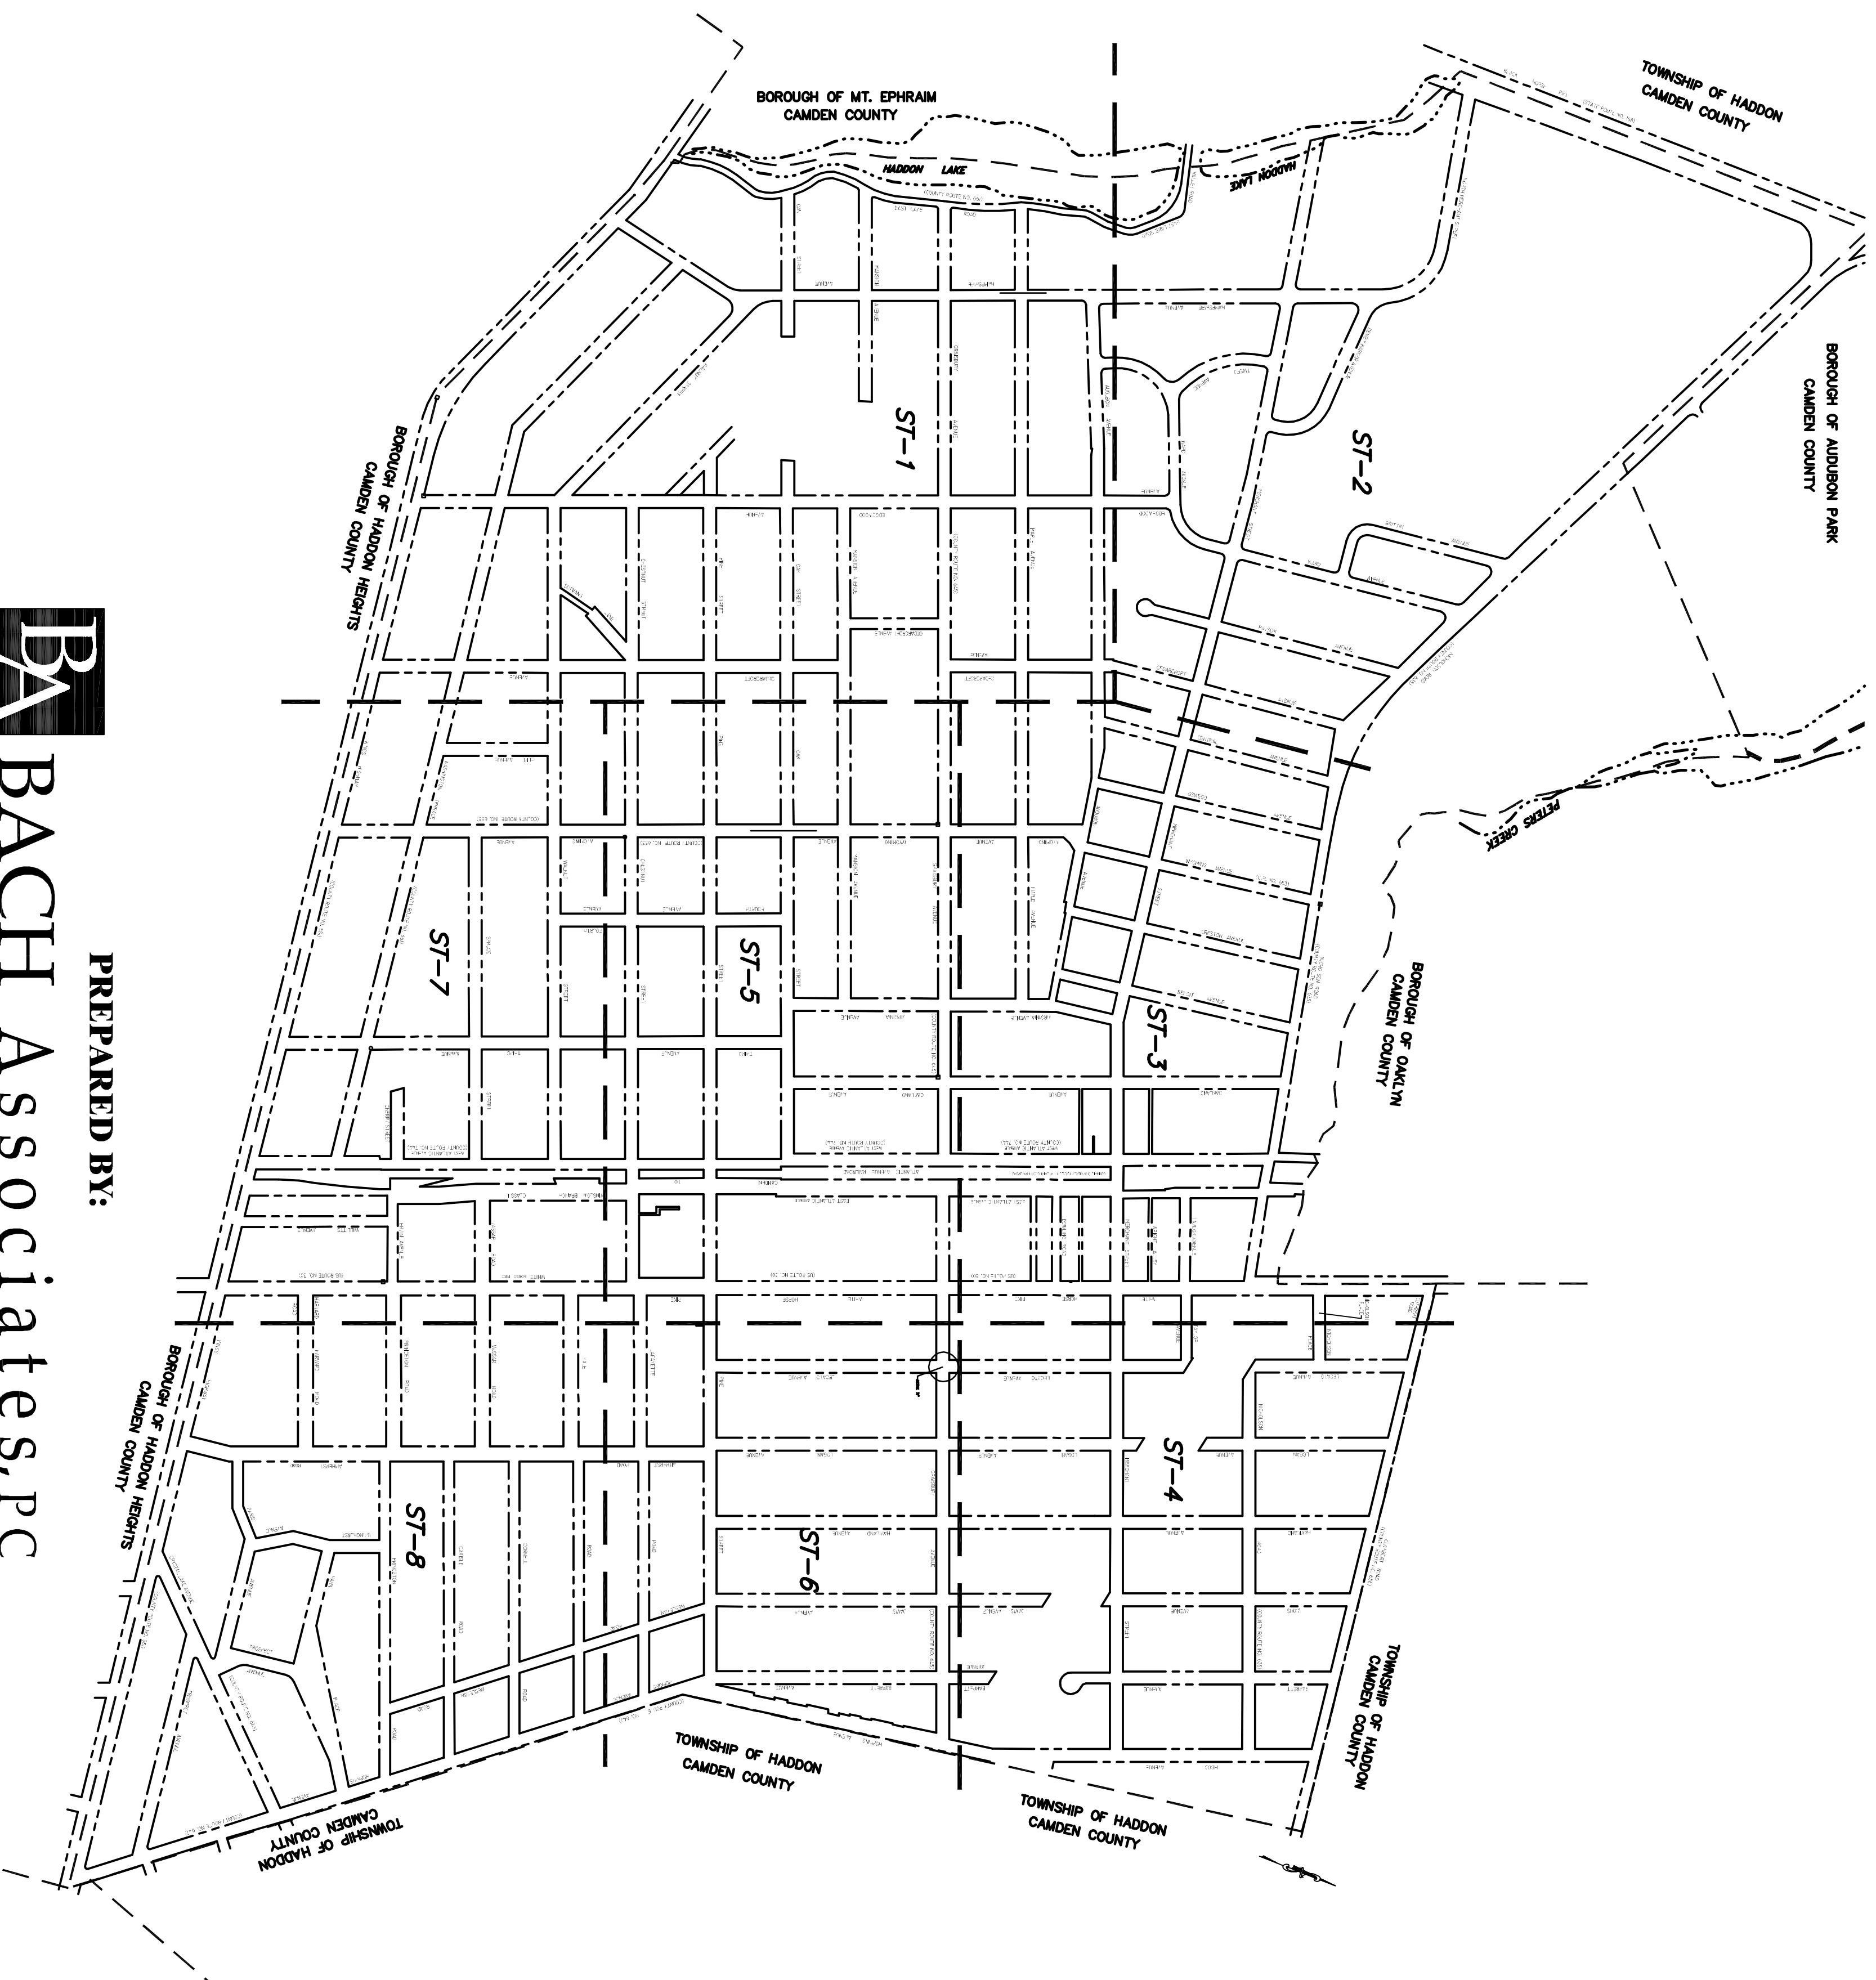

PREPARED BY:



BACH Associates, PC

ENGINEERS • ARCHITECTS • PLANNERS

304 White Horse Pike

Haddon Heights, New Jersey 08035

Tel: 856-546-8611

Fax: 856-546-8612

www.BachDesignGroup.com

Index of Drawings:

C-1	COVER SHEET
ST-1	STORM AS-BUILTS
ST-2	STORM AS-BUILTS
ST-3	STORM AS-BUILTS
ST-4	STORM AS-BUILTS
ST-5	STORM AS-BUILTS
ST-6	STORM AS-BUILTS
ST-7	STORM AS-BUILTS
ST-8	STORM AS-BUILTS



BACH Associates, PC
ENGINEERS • ARCHITECTS • PLANNERS

304 White Horse Pike

Haddon Heights, New Jersey 08035

Tel: 856-546-8611

Fax: 856-546-8612

www.BachDesignGroup.com

SCALE:


ANTHONY F. DIROSA, PE, PLS
N.J. PROFESSIONAL ENGINEER & LAND SURVEYOR NO. A98262000
ALL DIMENSIONS MUST BE VERIFIED BY OWNER OR CONTRACTOR. DIMENSIONS MUST BE NOTIFIED WITH THE WORK.
PROJECT:

STORM AS-BUILTS
BOROUGH OF AUDUBON
CAMDEN COUNTY, NEW JERSEY

NO.	DESCRIPTION	DATE

DRAWING TITLE:	
COVER SHEET	
JOB NO. A82016-3	DESIGNED BY:
DATE: 04/17/17	DRAWN BY: LML
SCALE: 1"=80'	CHECKED BY: AFD
DRAWING NUMBER:	

C-1

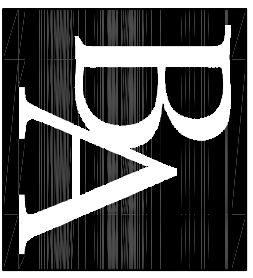

BACH Associates, P.C.
 ENGINEERS • ARCHITECTS • PLANNERS
 304 White Horse Pike
 Haddon Heights, New Jersey 08035
 Tel: 856-546-8611
 Fax: 856-546-8612
 www.BachDesignGroup.com

ANTHONY F. DIROSA, P.E., P.L.S.
 N.J. PROFESSIONAL ENGINEER & LAND SURVEYOR NO. 248620000

ALL DIMENSIONS MUST BE VERIFIED BY
 OWNER OR LANDOWNER. ALL DIMENSIONS
 GIVEN ON THIS DRAWING ARE TO BE
 CONSIDERED APPROVED UNLESS NOTED
 OTHERWISE. THE CONTRACTOR SHALL BE
 RESPONSIBLE FOR VERIFYING ALL DIMENSIONS
 WITH THE WORK.

PROJECT:

STORM AS-BUILTS
 BOROUGH OF AUDUBON
 CAMDEN COUNTY, NEW JERSEY


NO. DESCRIPTION DATE

DRAWING TITLE:

STORM AS-BUILTS

JOB NO. A02016-3	DESIGNED BY:
DATE 04/17/17	DRAWN BY: LML
SCALE: 1"=200'	CHECKED BY: AFD
DRAWING NUMBER:	

STORM AS-BUILTS
 SCALE: 1" = 200'
 200 0 200 400
 Feet

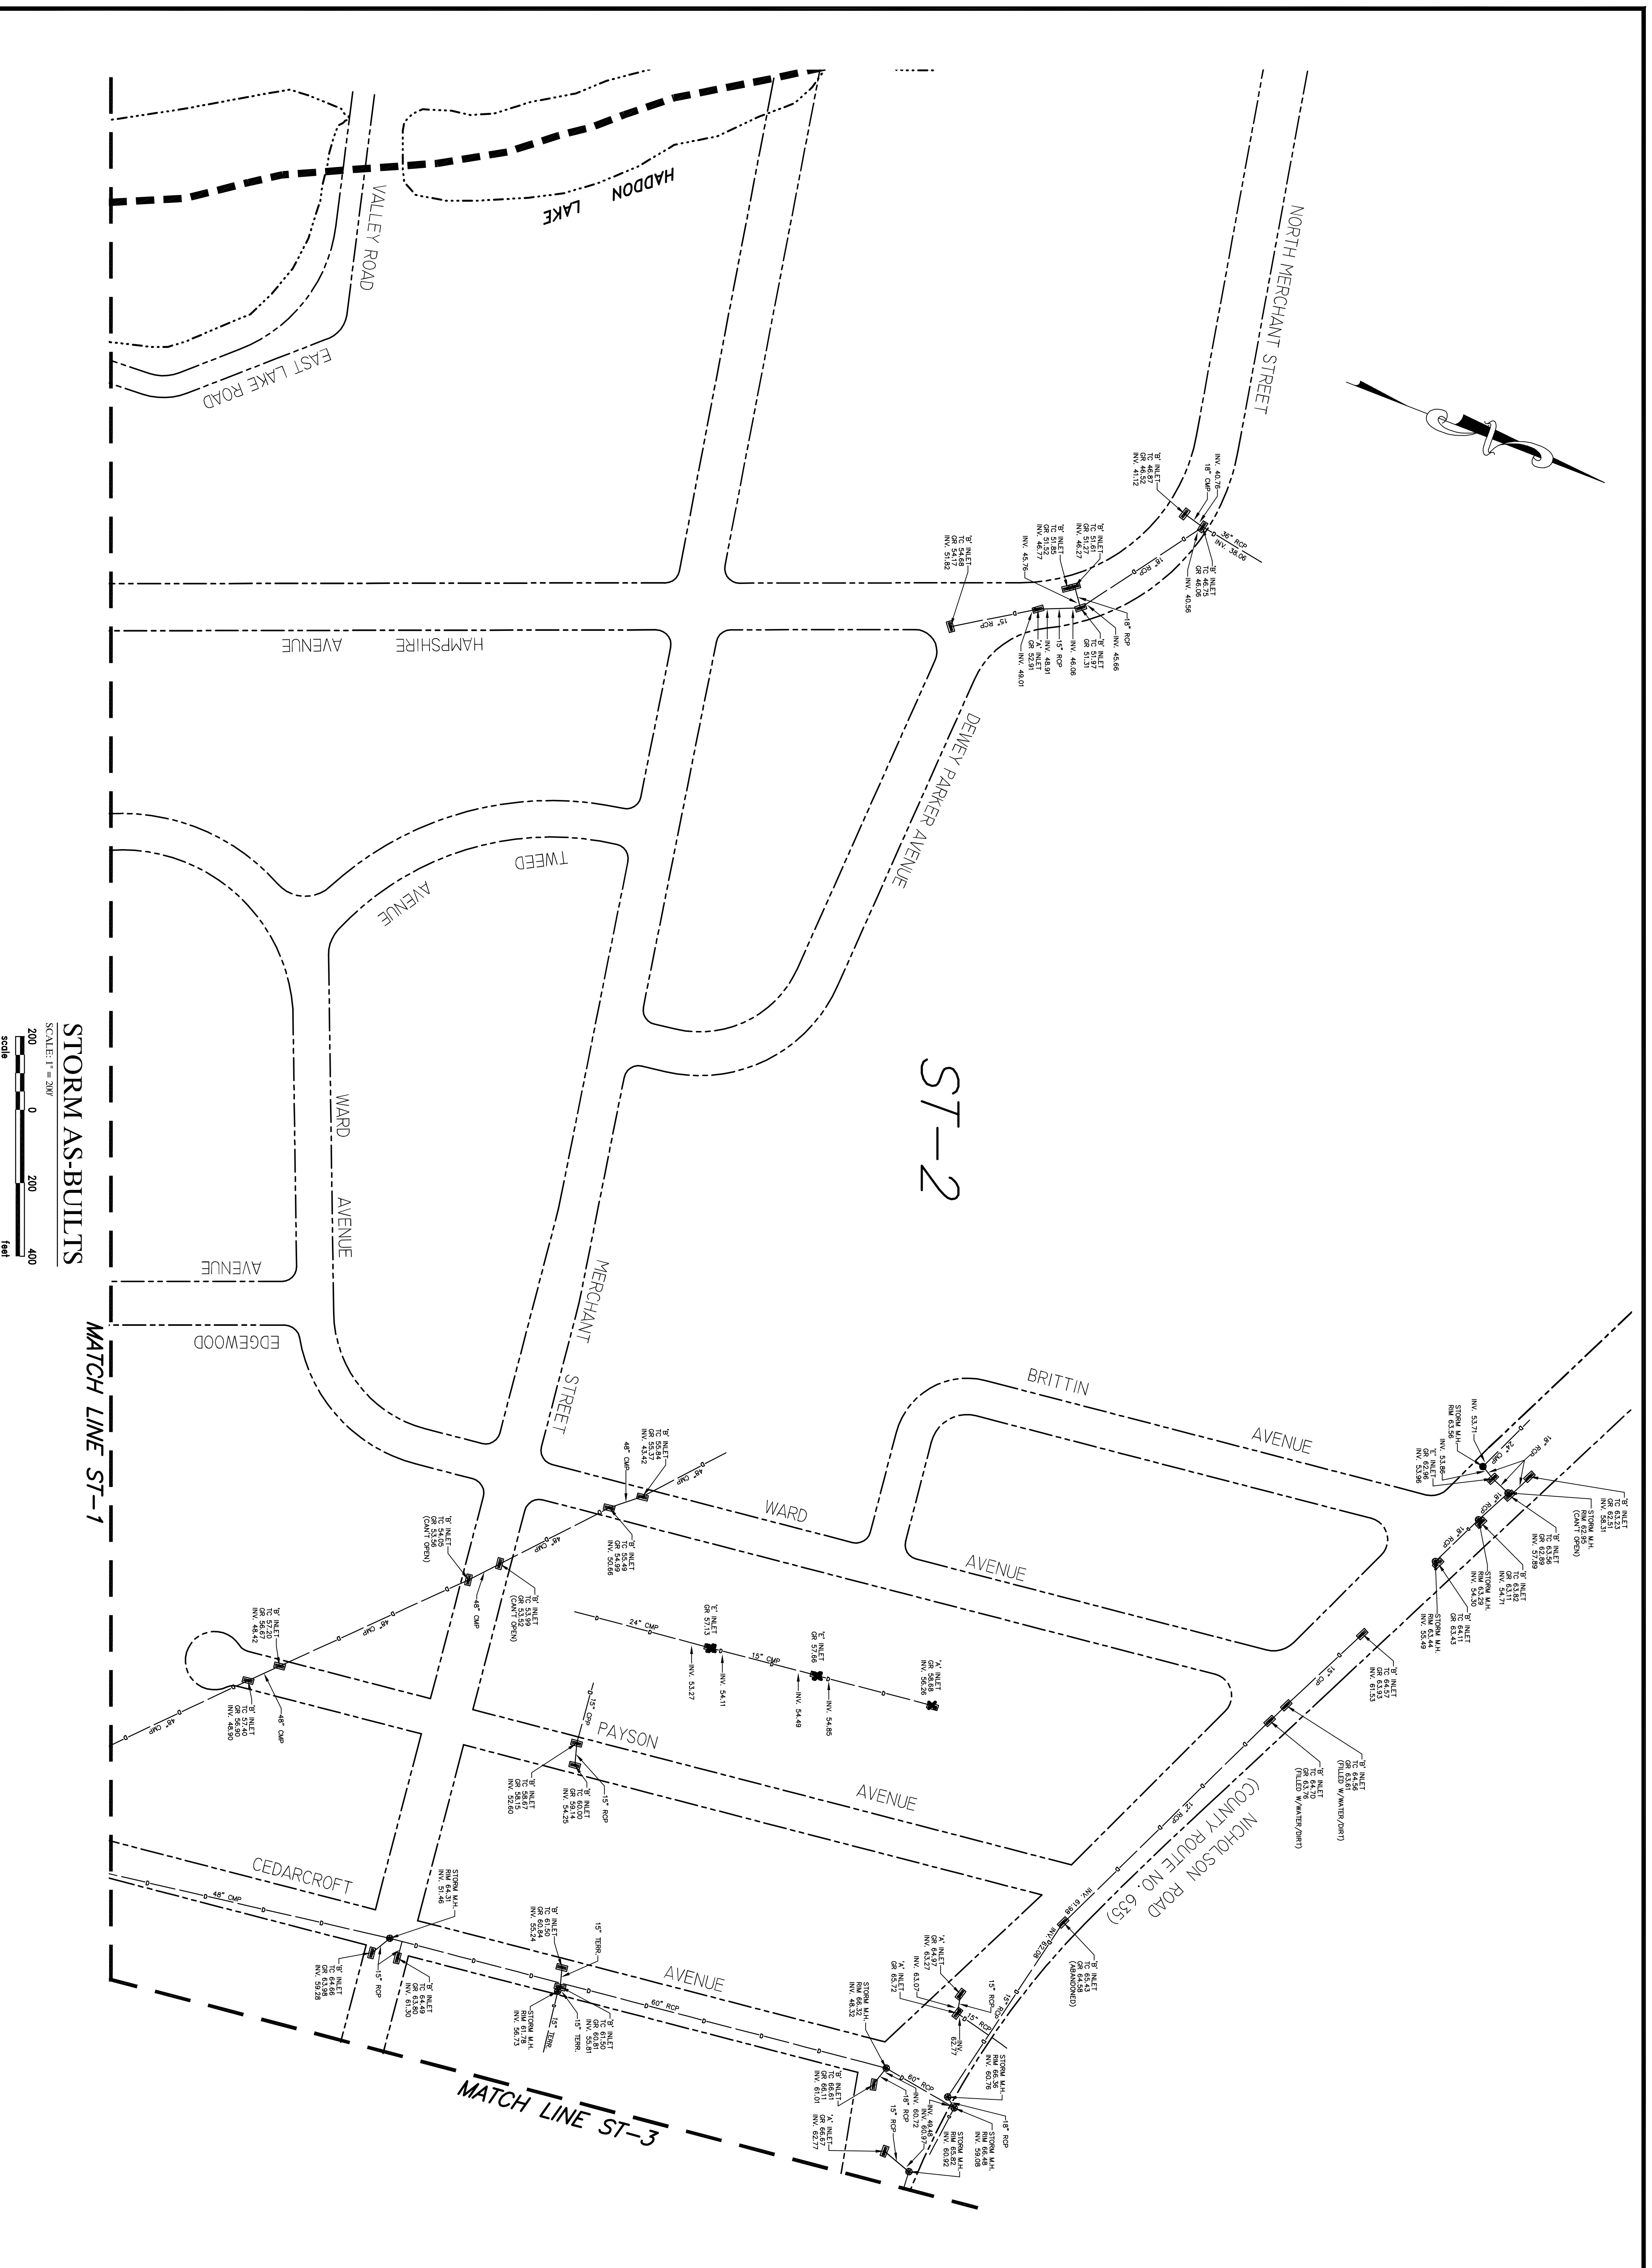

BOROUGH OF OAKLYN
CAMDEN COUNTY

PETER CREEK

NICHOLSON PLACE

BACH Associates, PC
ENGINEERS • ARCHITECTS • PLANNERS
304 White Horse Pike
Haddon Heights, New Jersey 08035
Tel: 856-546-8611
Fax: 856-546-8612
www.BachDesignGroup.com



SCALE:

ANTHONY F. DIROSA, PE, PLS
N.J. PROFESSIONAL ENGINEER & LAND SURVEYOR NO. 748690200
ALL DIMENSIONS MUST BE VERIFIED BY OWNER OR LANDOWNER. MUST BE NOTIFIED BY OWNER OR LANDOWNER BEFORE PROCEEDING WITH THE WORK.
PROJECT:


STORM AS-BUILTS
BOROUGH OF AUDUBON
CAMDEN COUNTY, NEW JERSEY

NO.	DESCRIPTION	DATE

STORM AS-BUILTS

JOB NO. A202016-3	DESIGNED BY:
DATE 04/17/17	DRAWN BY: LML
SCALE: 1"=200'	CHECKED BY: AFD
DRAWING NUMBER:	

STORM AS-BUILTS
SCALE: 1" = 200'
200 0 200 400
Scale Feet

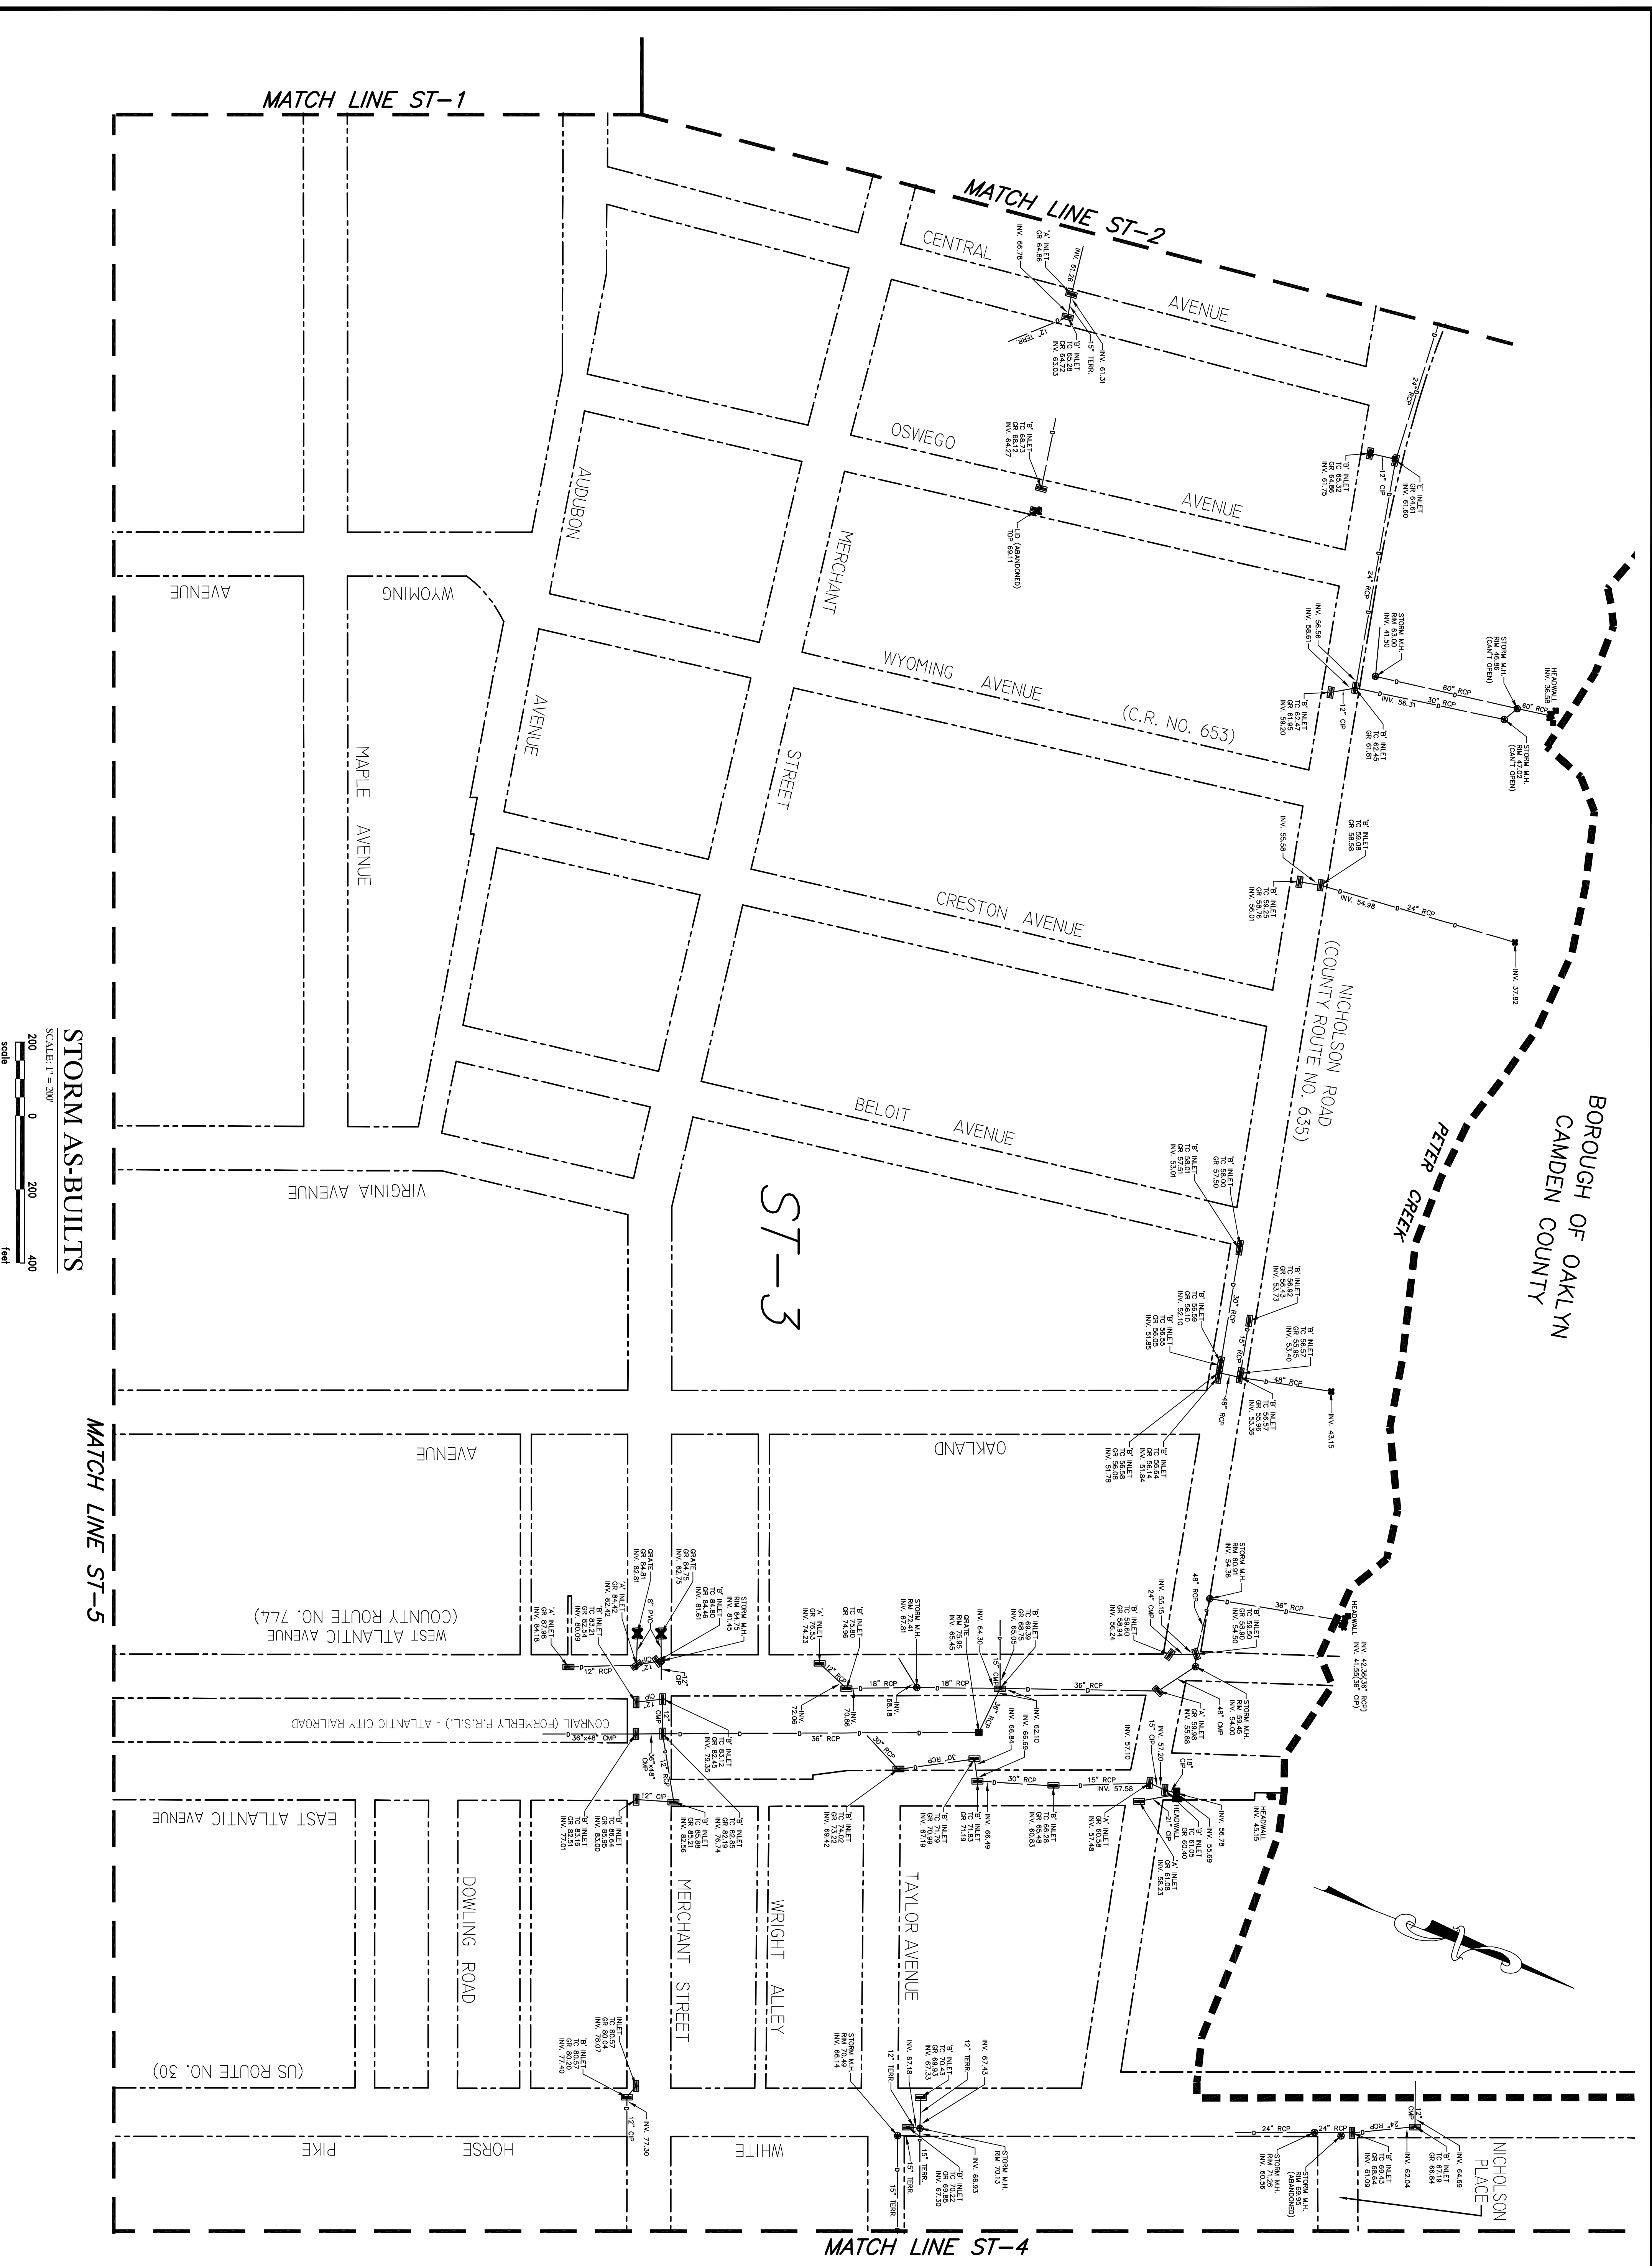



BACH Associates, P.C.
 ENGINEERS • ARCHITECTS • PLANNERS
 304 White Horse Pike
 Haddon Heights, New Jersey 08035
 Tel: 856-546-8611
 Fax: 856-546-8612
 www.BachDesignGroup.com

SCALE:

ANTHONY F. DIROSA, P.E., P.L.S.
 N.J. PROFESSIONAL ENGINEER & LAND SURVEYOR NO. 348902000
 ALL DIMENSIONS MUST BE VERIFIED BY
 OWNER OR LANDOWNER. MUST BE NOTIFIED
 OF ANY CHANGES BEFORE PROCEEDING
 WITH THE WORK.
 PRODUCT:

STORM AS-BUILTS
 BOROUGH OF AUDUBON
 CAMDEN COUNTY, NEW JERSEY


NO. DESCRIPTION DATE
 REVISIONS

DRAWING TITLE:

STORM AS-BUILTS

JOB NO.	DESIGNED BY:
ADDITIONAL:	
DATE:	DRAWN BY:
04/17/17	LML
SCALE:	CHECKED BY:
1" = 100'	AFD
DRAWING NUMBER:	

STORM AS-BUILTS
 SCALE: 1" = 100'
 100 0 100 200
 Scale Feet

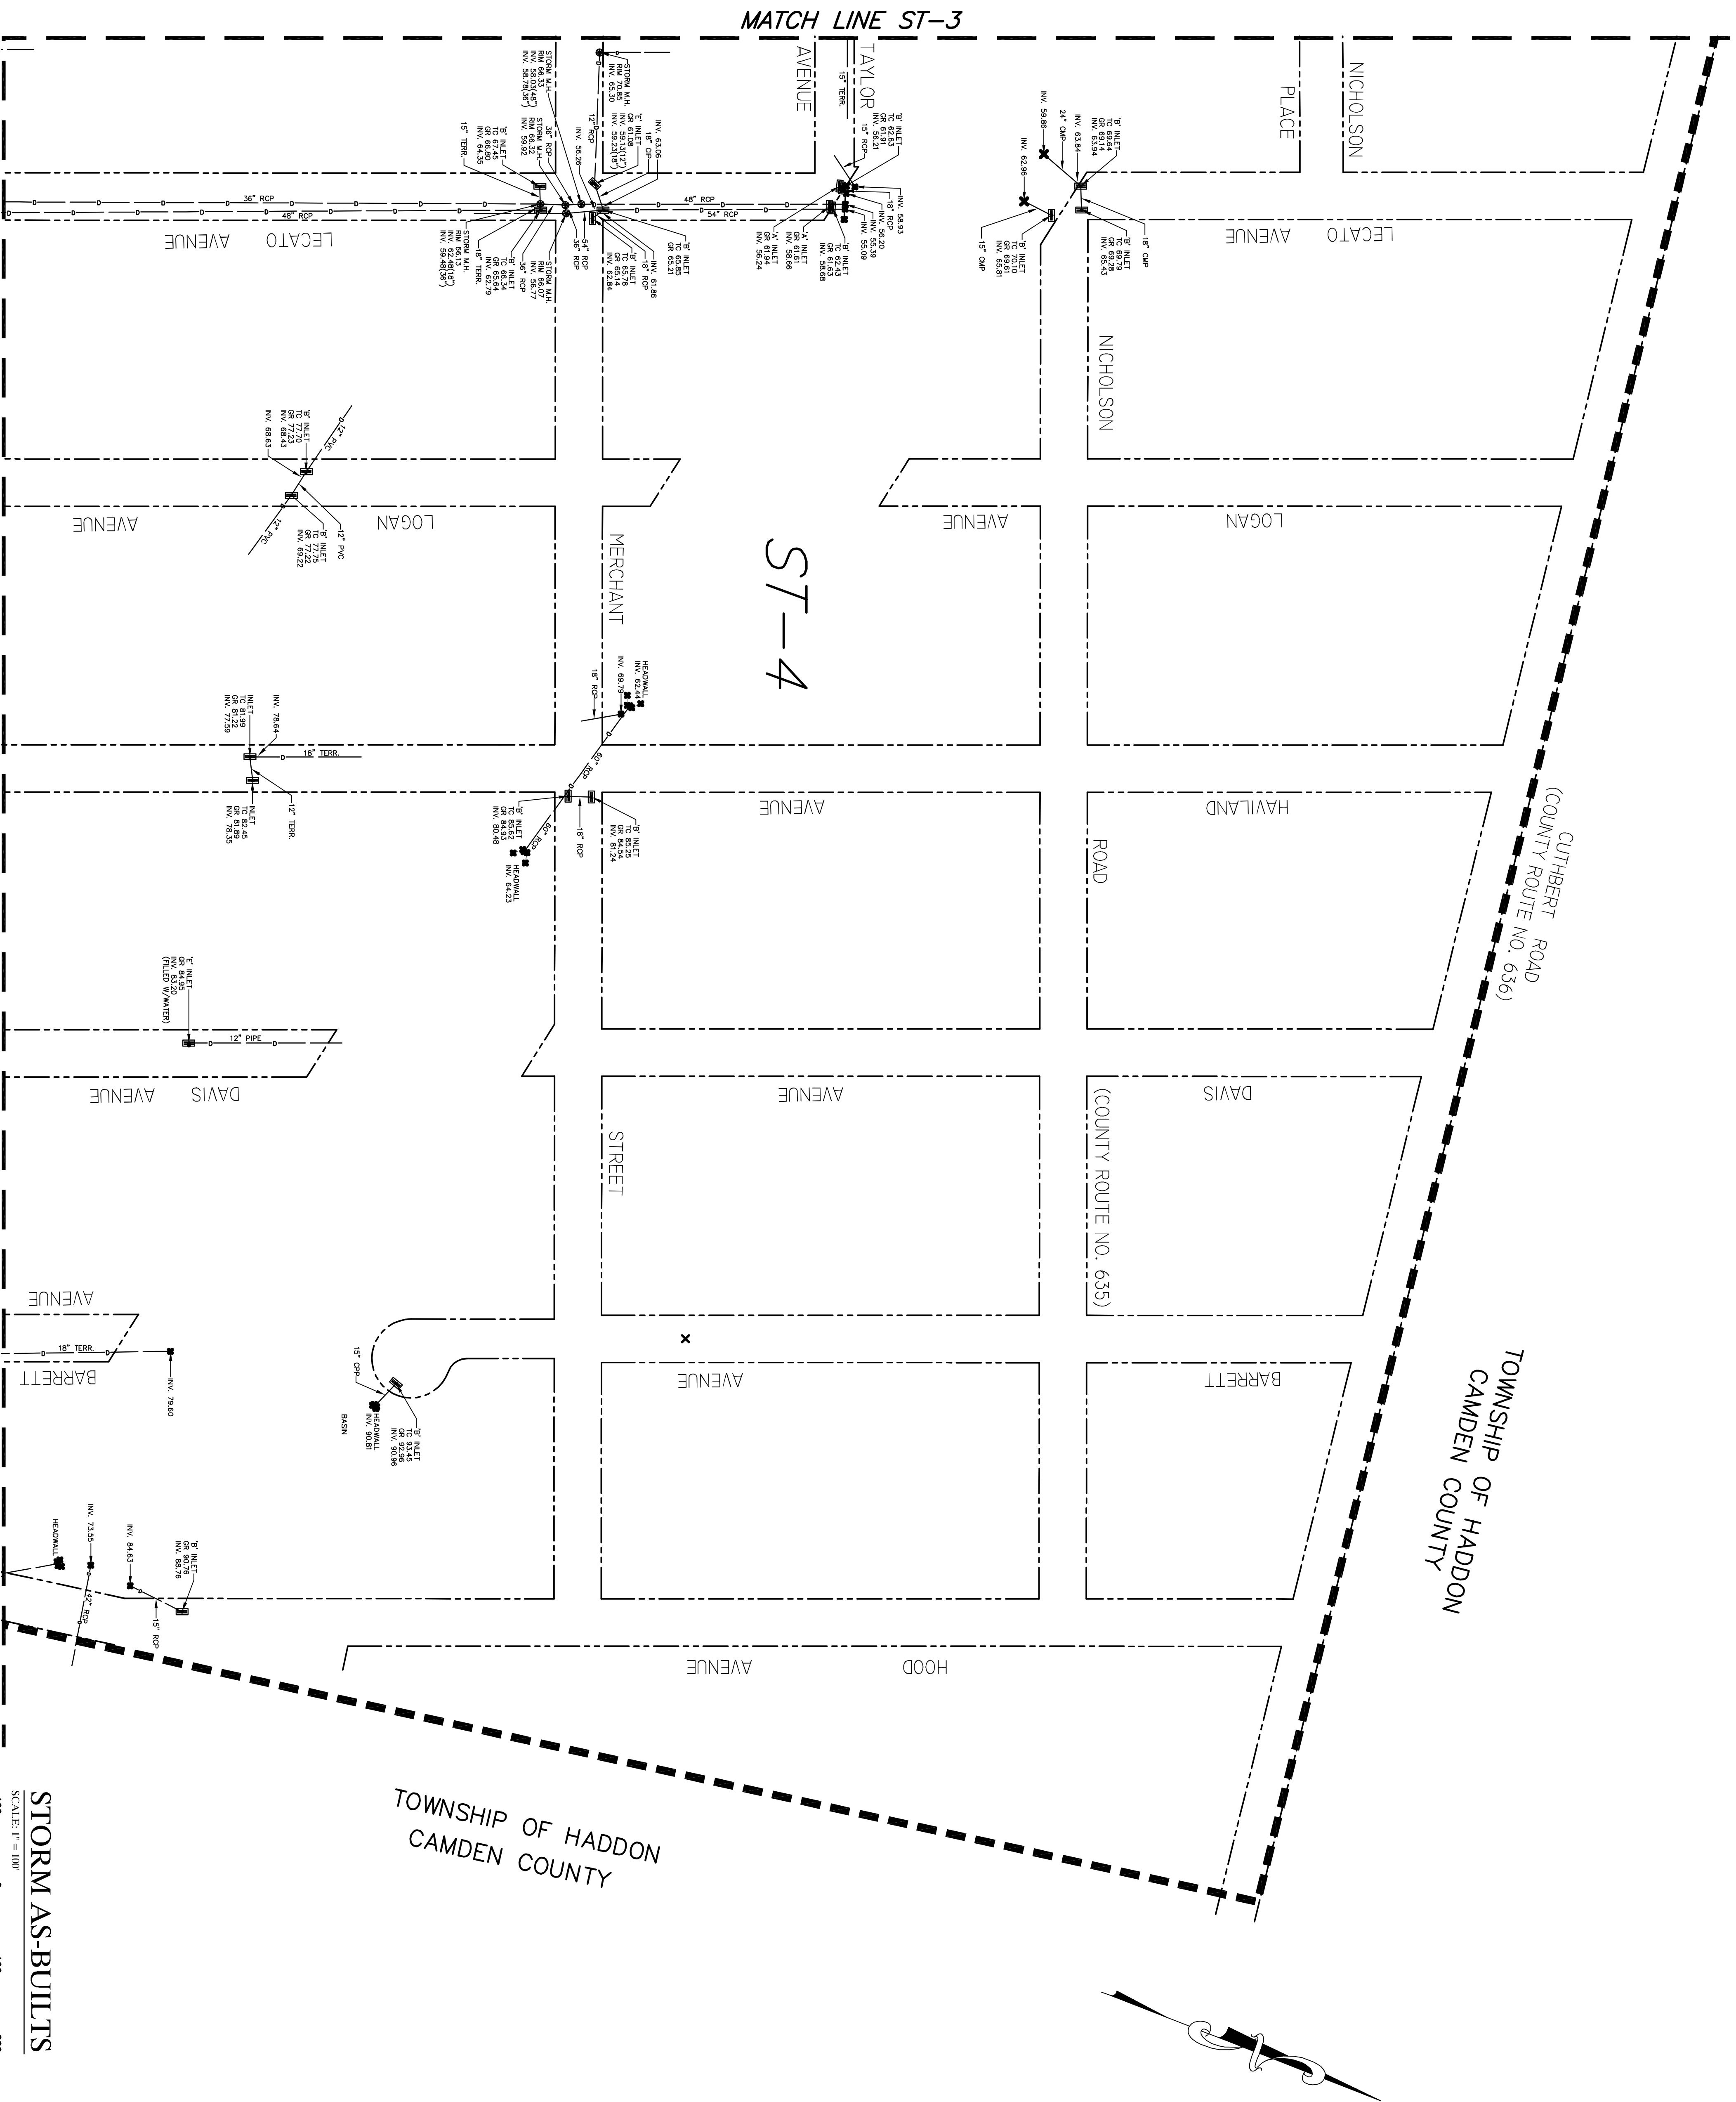



BACH Associates, PC
 ENGINEERS • ARCHITECTS • PLANNERS
 304 White Horse Pike
 Haddon Heights, New Jersey 08035
 Tel: 856-546-8611
 Fax: 856-546-8612
 www.BachDesignGroup.com

ANTHONY F. DIROSA, PE, PLS
 N.J. PROFESSIONAL ENGINEER & LAND SURVEYOR NO. 248902000
 ALL DIMENSIONS MUST BE VERIFIED BY
 OWNER OR LANDOWNER. MOST BE NOTIFIED
 OF ANY CHANGES BEFORE PROCEEDING
 WITH THE WORK.


STORM AS-BUILTS
 BOROUGH OF AUDUBON
 CAMDEN COUNTY, NEW JERSEY

NO.	DESCRIPTION	DATE



DRAWING TITLE:

STORM AS-BUILTS


JOB NO.	DESIGNED BY:
AS2011-6-3	
DATE:	DRAWN BY:
04/17/17	LML
SCALE:	CHECKED BY:
1" = 100'	AFD
DRAWING NUMBER:	

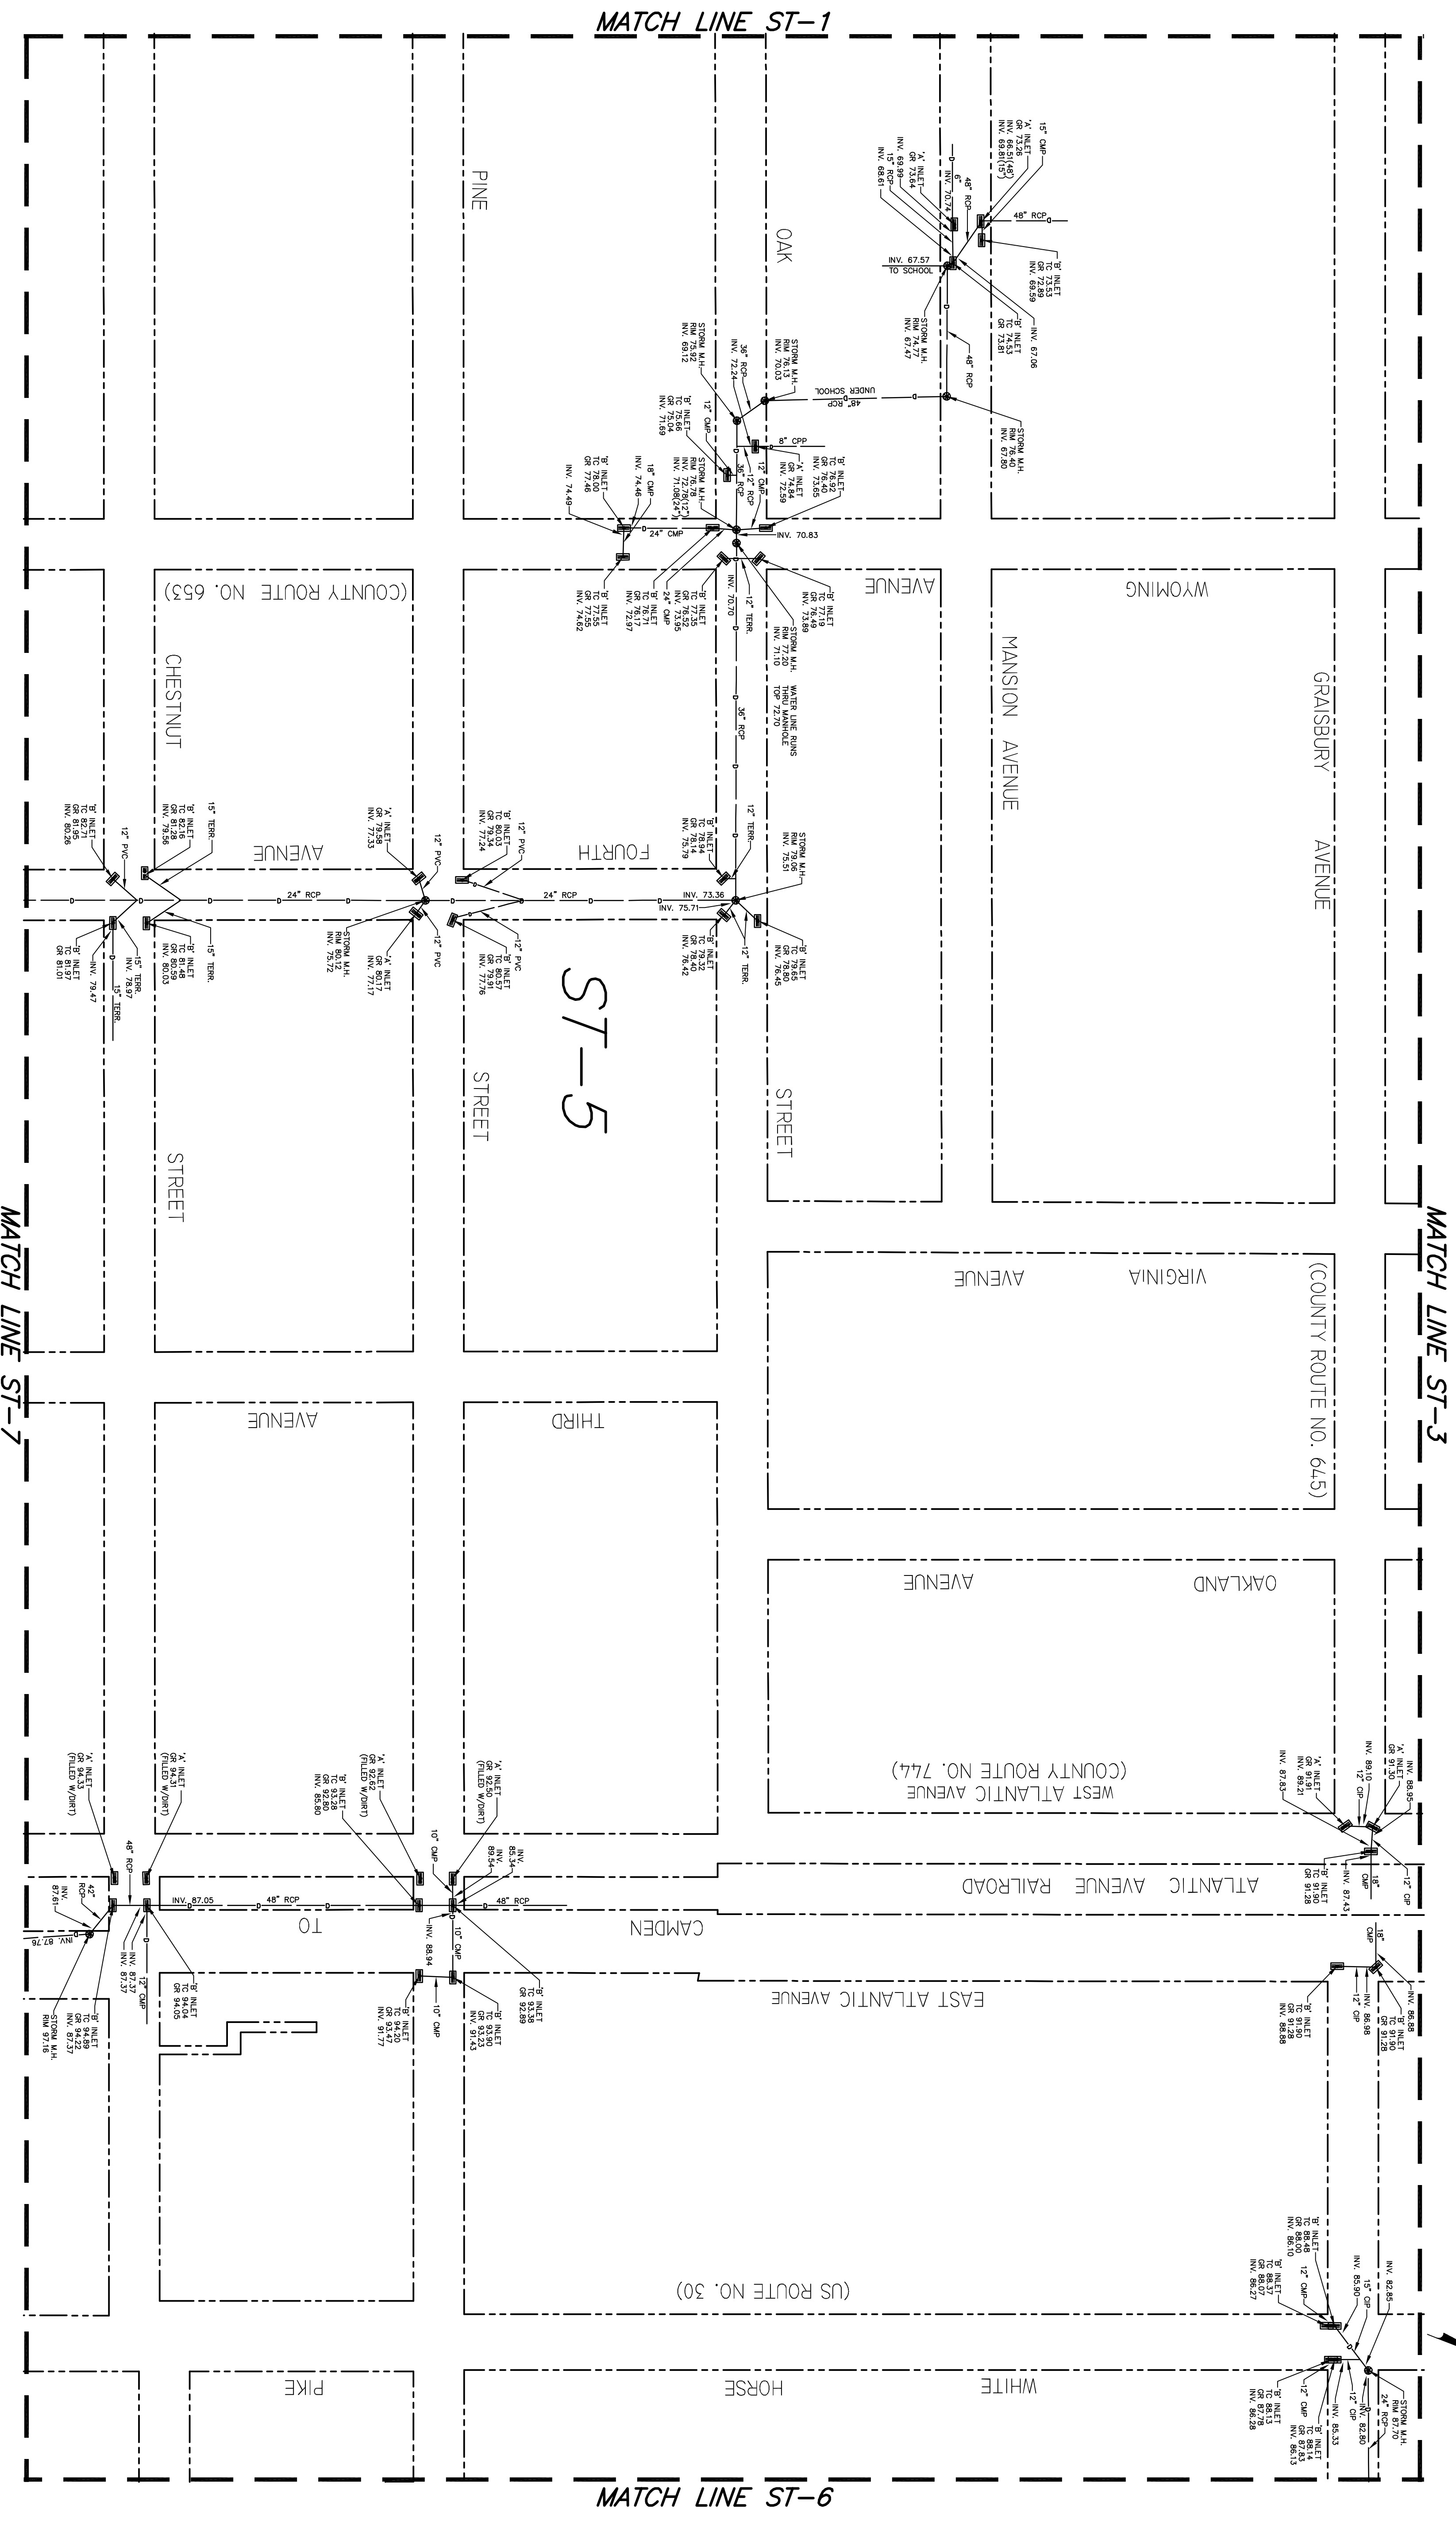

STORM AS-BUILTS
 SCALE: 1" = 100'
 100 0 100 200
 Feet

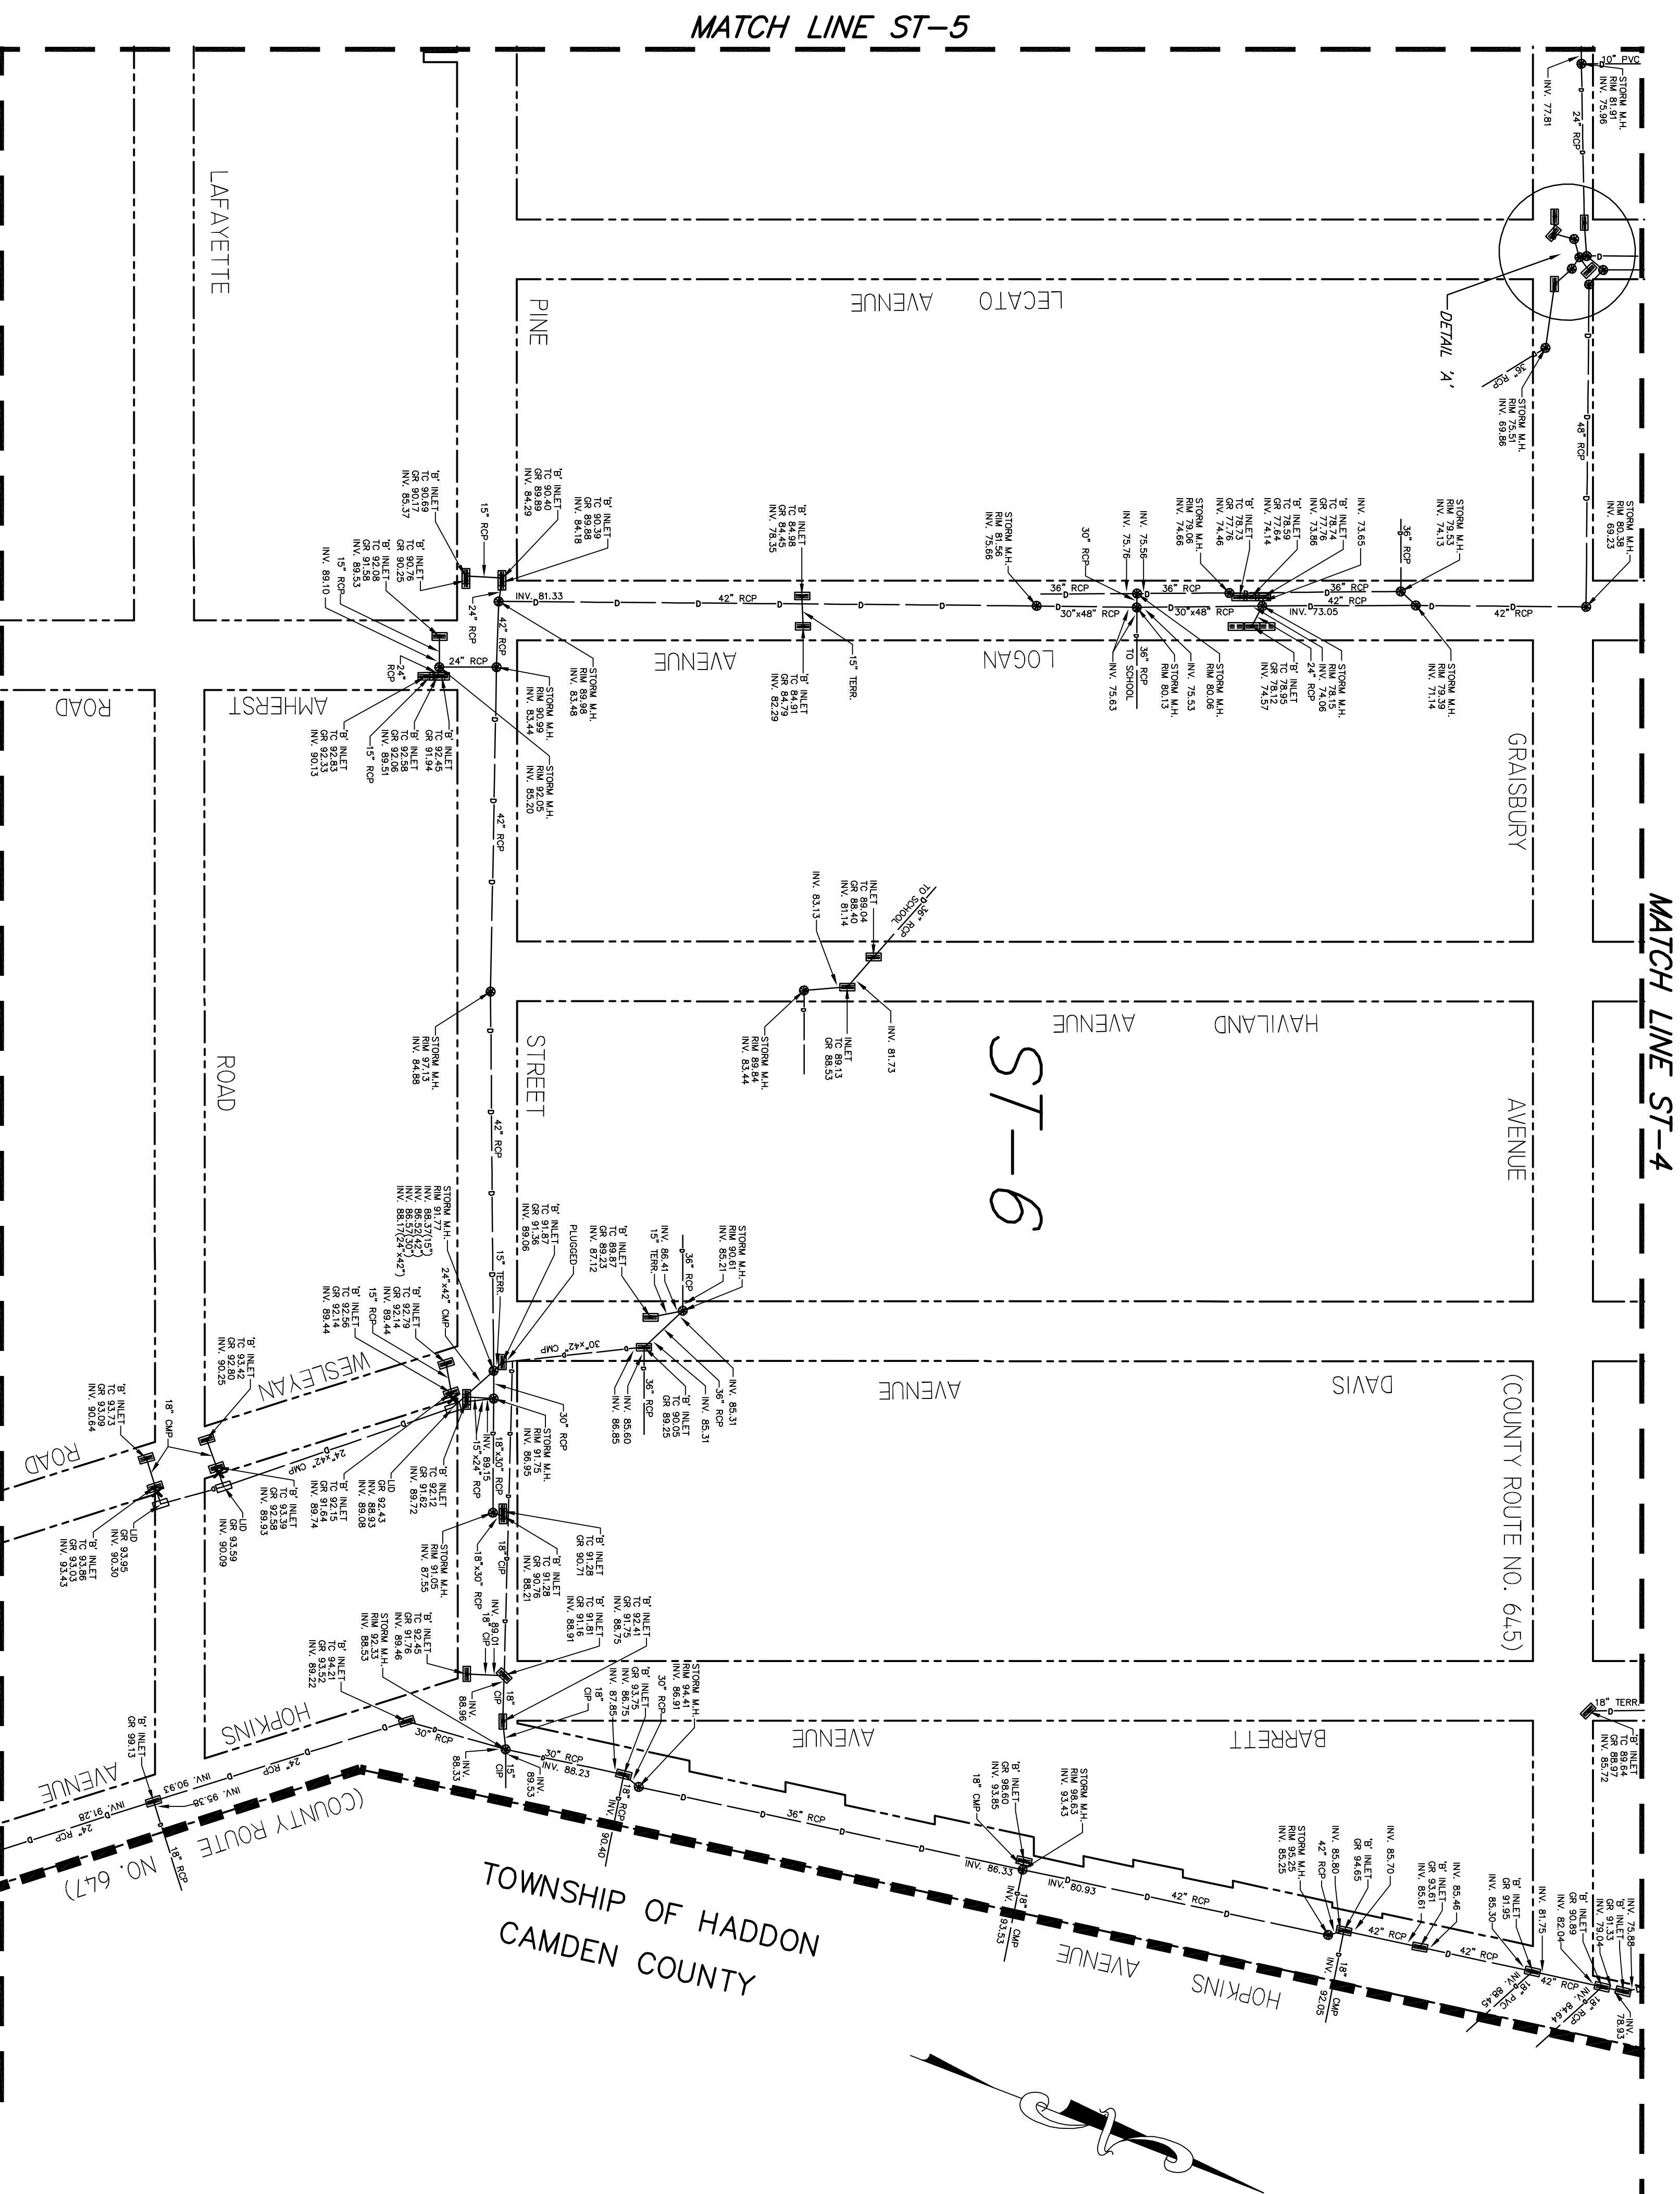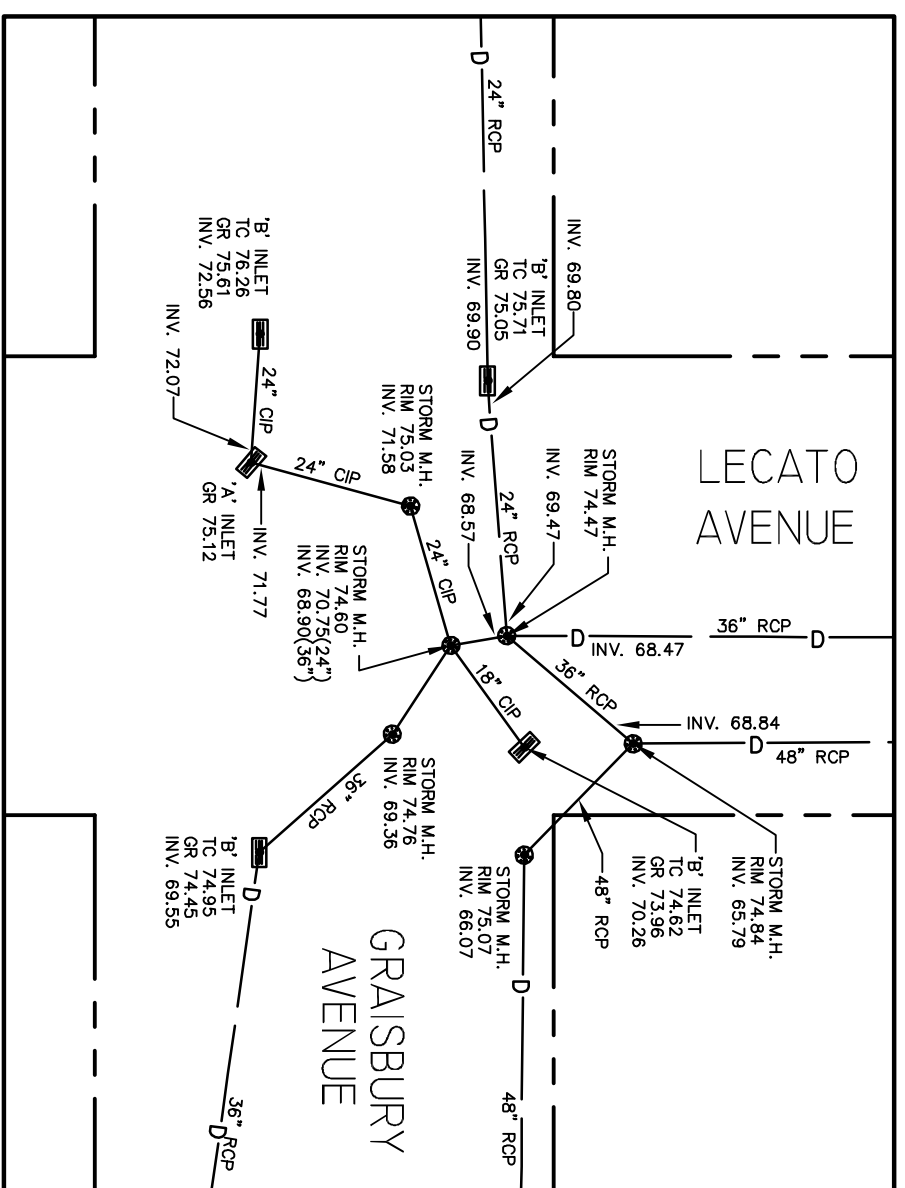

STORM AS-BUILTS
 SCALE: 1" = 100'
 100 0 100 200
 Scale Feet

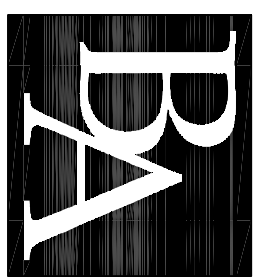

BACH Associates, P.C.
 ENGINEERS • ARCHITECTS • PLANNERS
 304 White Horse Pike
 Haddon Heights, New Jersey 08035
 Tel: 856-546-8611
 Fax: 856-546-8612
 www.BachDesignGroup.com

ANTHONY F. DIROSA, P.E., P.L.S.
 N.J. PROFESSIONAL ENGINEER & LAND SURVEYOR NO. 248920000
 ALL DIMENSIONS MUST BE VERIFIED BY CONTRACTOR AND OWNER MUST BE NOTIFIED OF ANY DISCREPANCIES BEFORE PROCEEDING WITH THE WORK.
 PRODUCT:

STORM AS-BUILTS
 BOROUGH OF AUDUBON
 CAMDEN COUNTY, NEW JERSEY

NO.	DESCRIPTION	DATE

DRAWING TITLE:
STORM AS-BUILTS

JOB NO. AUDUBON-3	DESIGNED BY:
DATE: 04/17/17	DRAWN BY:
SCALE: 1" = 100'	CHECKED BY:
DRAWING NUMBER:	APP:

ST-6



BACH Associates, P.C.
 ENGINEERS • ARCHITECTS • PLANNERS
 304 White Horse Pike
 Haddon Heights, New Jersey 08035
 Tel: 856-546-8611
 Fax: 856-546-8612
 www.BachDesignGroup.com

SCALE:

ANTHONY F. DIROSA, P.E., P.L.S.
 N.J. PROFESSIONAL ENGINEER & LAND SURVEYOR NO. 248000000
 ALL DIMENSIONS MUST BE VERIFIED BY CONTRACTOR AND OWNER MUST BE NOTIFIED OF ANY DISCREPANCIES BEFORE PROCEEDING WITH THE WORK.
 PROJECT:

STORM AS-BUILTS
 BOROUGH OF AUDUBON
 CAMDEN COUNTY, NEW JERSEY


NO. DESCRIPTION DATE
 REVISIONS

DRAWING TITLE:

STORM AS-BUILTS

JOB NO.	DESIGNED BY:
AD20216-3	
DATE:	DRAWN BY:
04/17/17	LML
SCALE:	CHECKED BY:
1" = 100'	AFD
DRAWING NUMBER:	

STORM AS-BUILTS
 SCALE: 1" = 100'
 100 0 100 200
 Feet

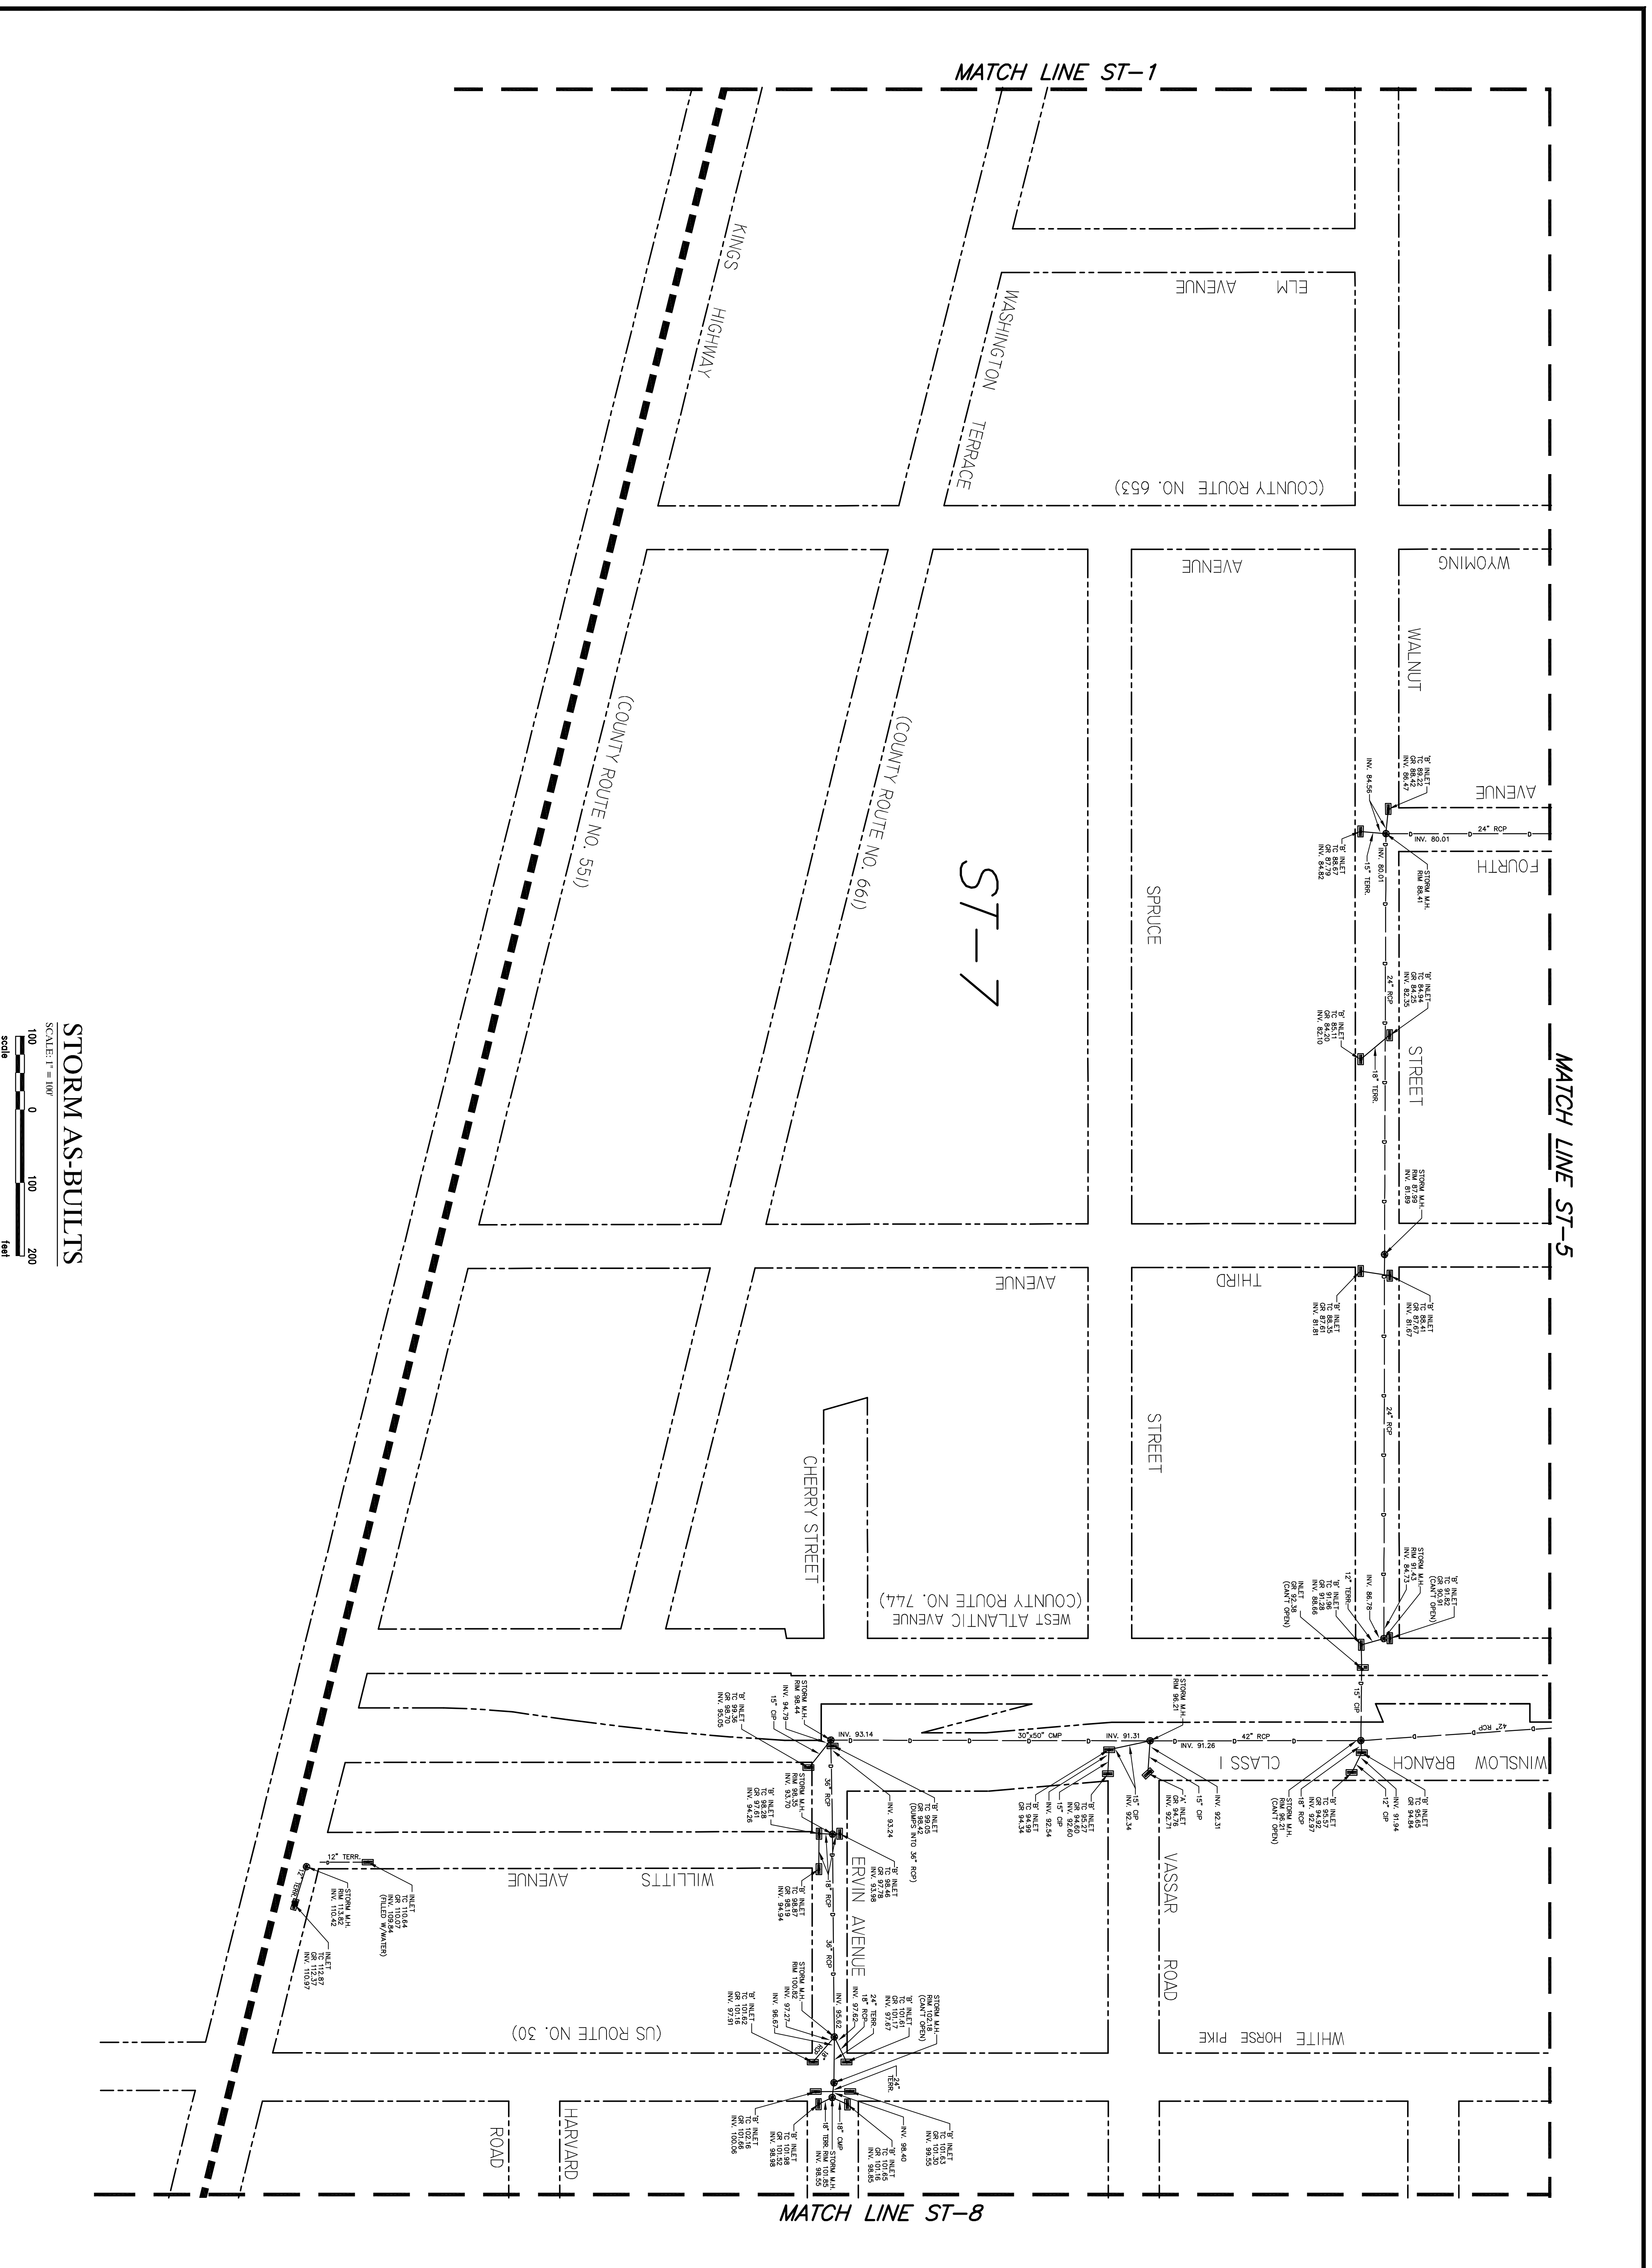

MATCH LINE ST-1

MATCH LINE ST-5

MATCH LINE ST-8



BACH Associates, PC
 ENGINEERS • ARCHITECTS • PLANNERS
 304 White Horse Pike
 Haddon Heights, New Jersey 08035
 Tel: 856-546-8611
 Fax: 856-546-8612
 www.BachDesignGroup.com

SCALE:

ANTHONY F. DIROSA, P.E., P.L.S.
 N.J. PROFESSIONAL ENGINEER & LAND SURVEYOR NO. 248902000
 ALL DIMENSIONS MUST BE VERIFIED BY
 OWNER OR LANDOWNER. MUST BE NOTIFIED
 IMMEDIATELY OF ANY DISCREPANCIES BEFORE PROCEEDING
 WITH THE WORK.
 PROJECT:


STORM AS-BUILTS
 BOROUGH OF AUDUBON
 CAMDEN COUNTY, NEW JERSEY

ALL DIMENSIONS PROVIDED BY BACH ASSOCIATES, PC ARE REPRESENTATIONS OF THE INFORMATION PROVIDED TO BACH ASSOCIATES, PC BY THE CLIENT. BACH ASSOCIATES, PC DOES NOT WARRANT THE ACCURACY OF THE INFORMATION PROVIDED TO BACH ASSOCIATES, PC. BACH ASSOCIATES, PC SHALL NOT BE RESPONSIBLE FOR ANY ERRORS OR OMISSIONS IN THE INFORMATION PROVIDED TO BACH ASSOCIATES, PC. BACH ASSOCIATES, PC SHALL NOT BE RESPONSIBLE FOR ANY ERRORS OR OMISSIONS IN THE INFORMATION PROVIDED TO BACH ASSOCIATES, PC. BACH ASSOCIATES, PC SHALL NOT BE RESPONSIBLE FOR ANY ERRORS OR OMISSIONS IN THE INFORMATION PROVIDED TO BACH ASSOCIATES, PC.

NO.	DESCRIPTION	DATE

DRAWING TITLE:
STORM AS-BUILTS

JOB NO. A02016-3	DESIGNED BY:
DATE: 04/17/17	DRAWN BY: LML
SCALE: 1" = 100'	CHECKED BY: AFD
DRAWING NUMBER: ST-8	

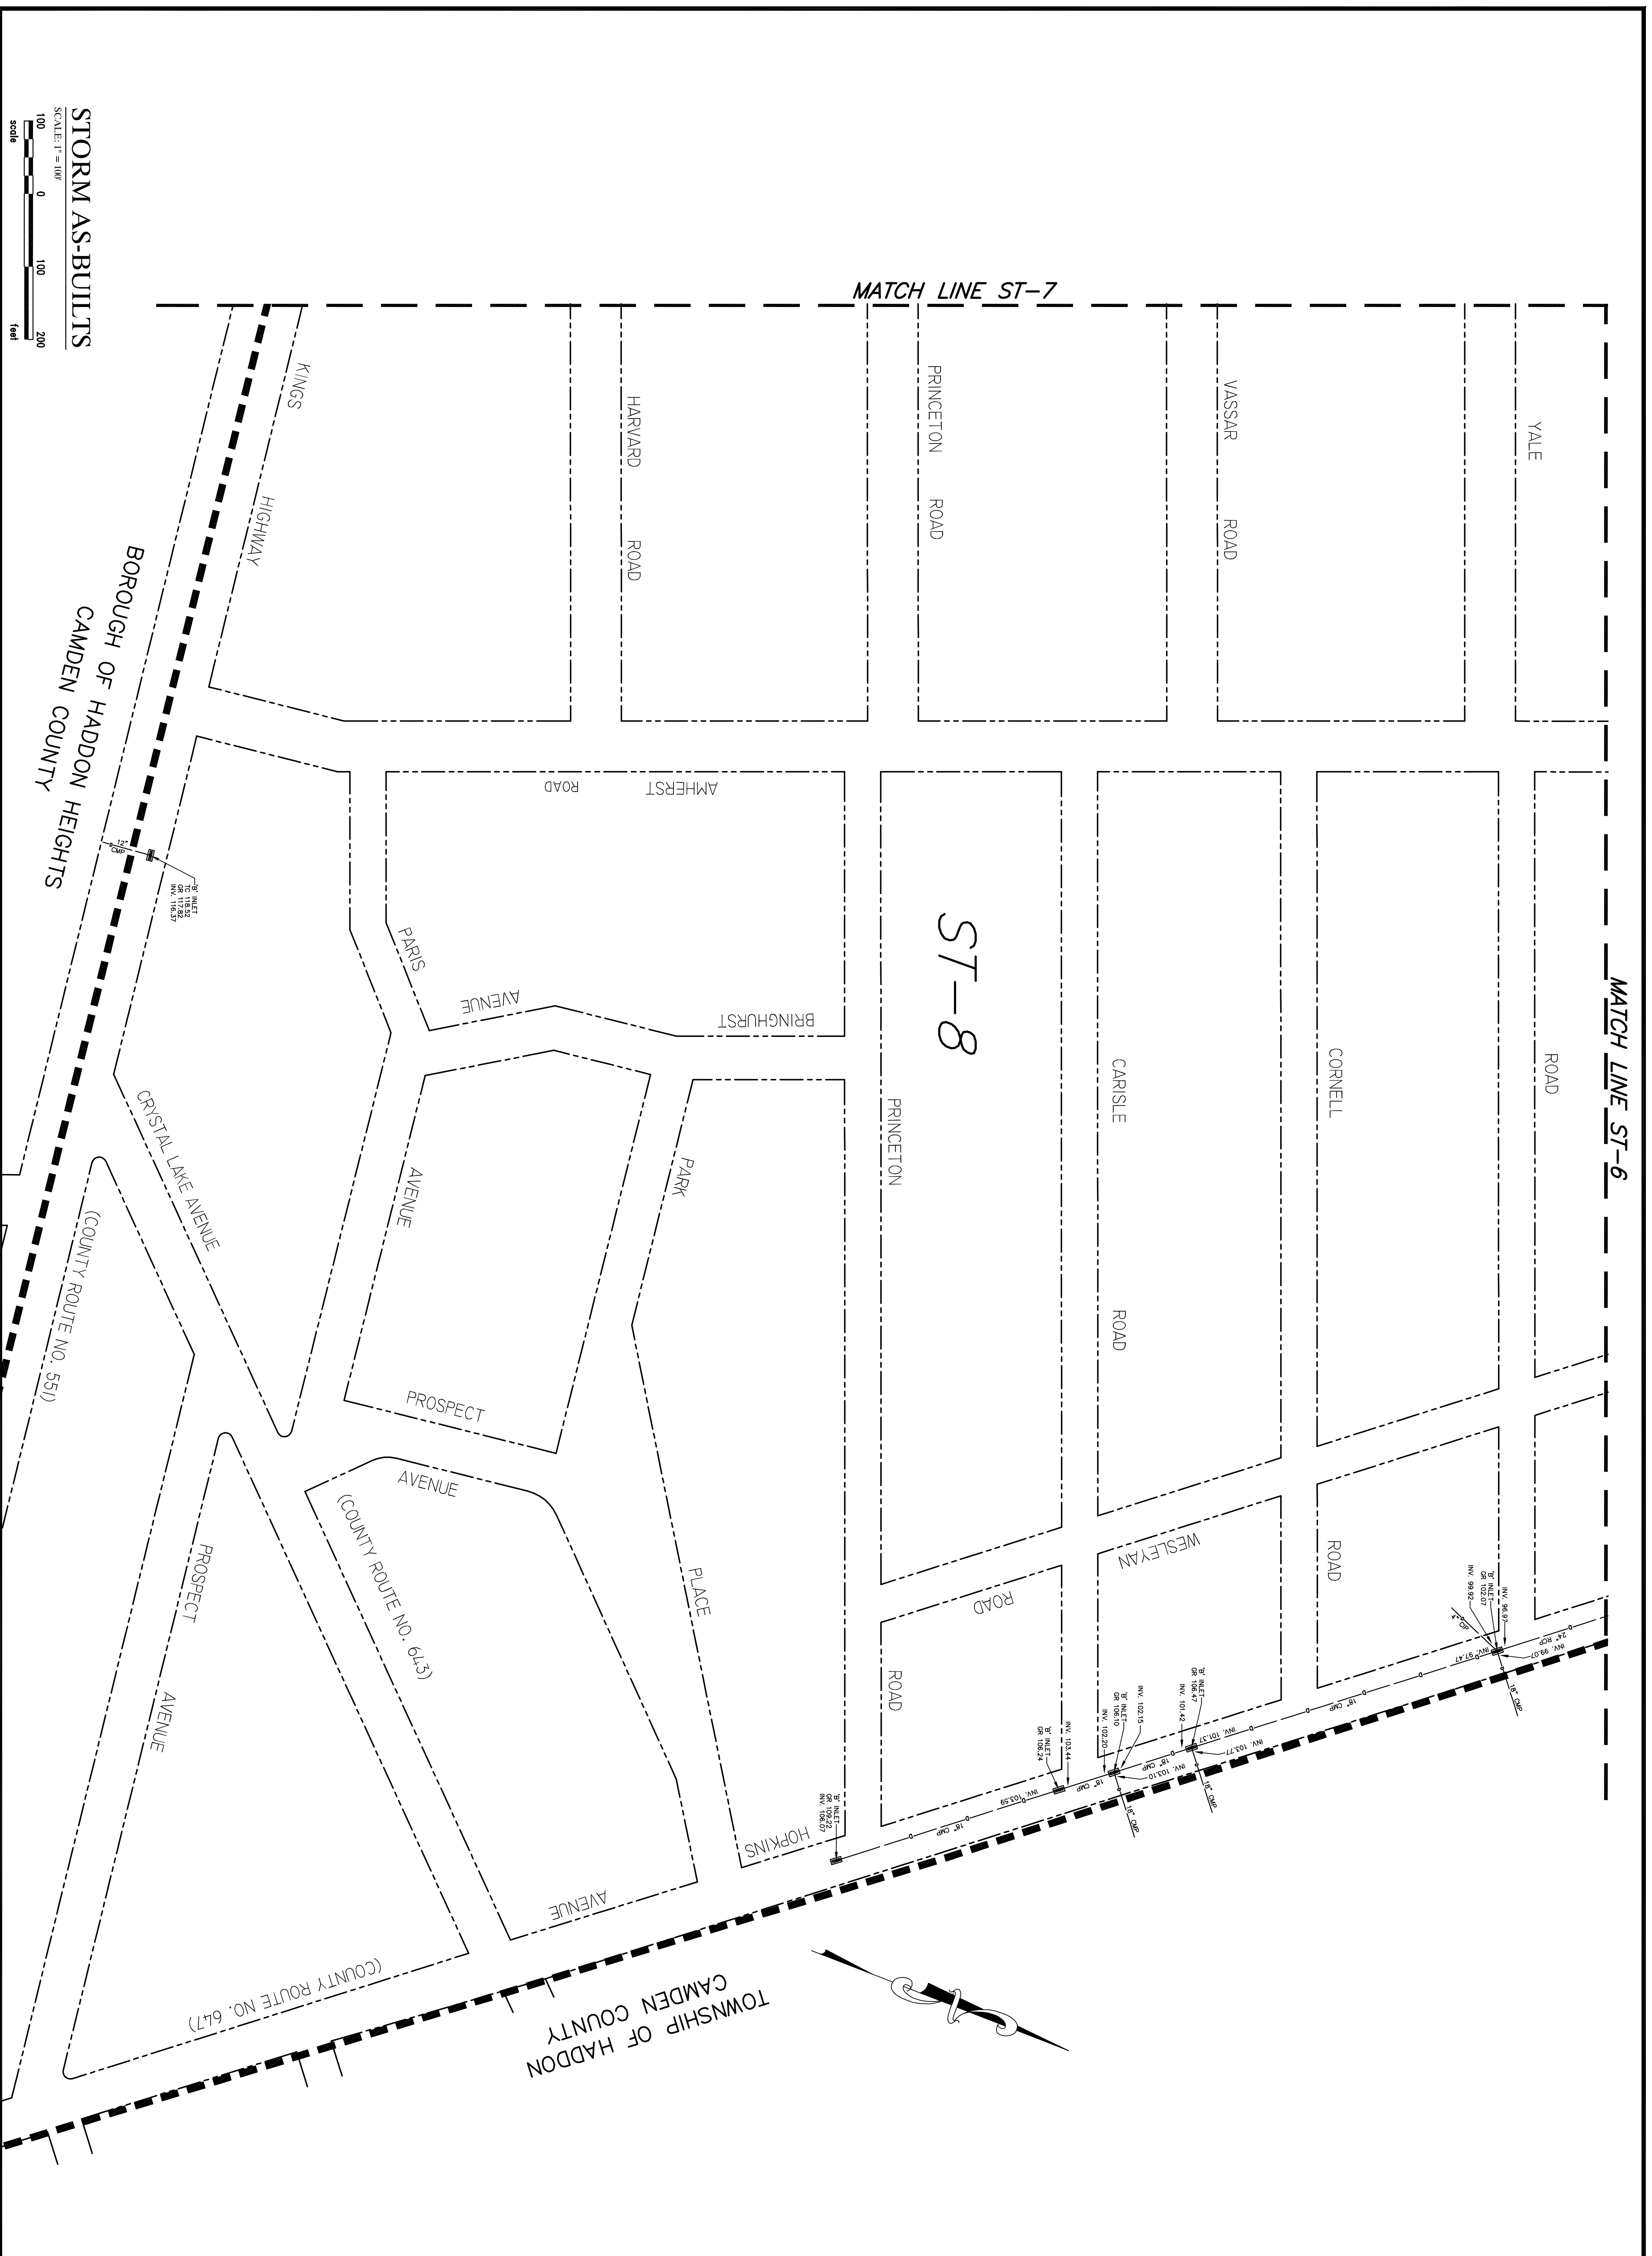

STORM AS-BUILTS
 SCALE: 1" = 100'
 100 0 100 200
 Feet